


Printed: Brad O'Malley ISO Expanded A4 (210.00 X 297.00 MM) Printed: 13 July 2017 S:\Projects\9276-Downer\ED\Works - Okareka Sewage Schemes\05 CHL Drawings\9276-106-INDIVIDUAL PROPERTY FILE\DWG\9276-106-A Sheets

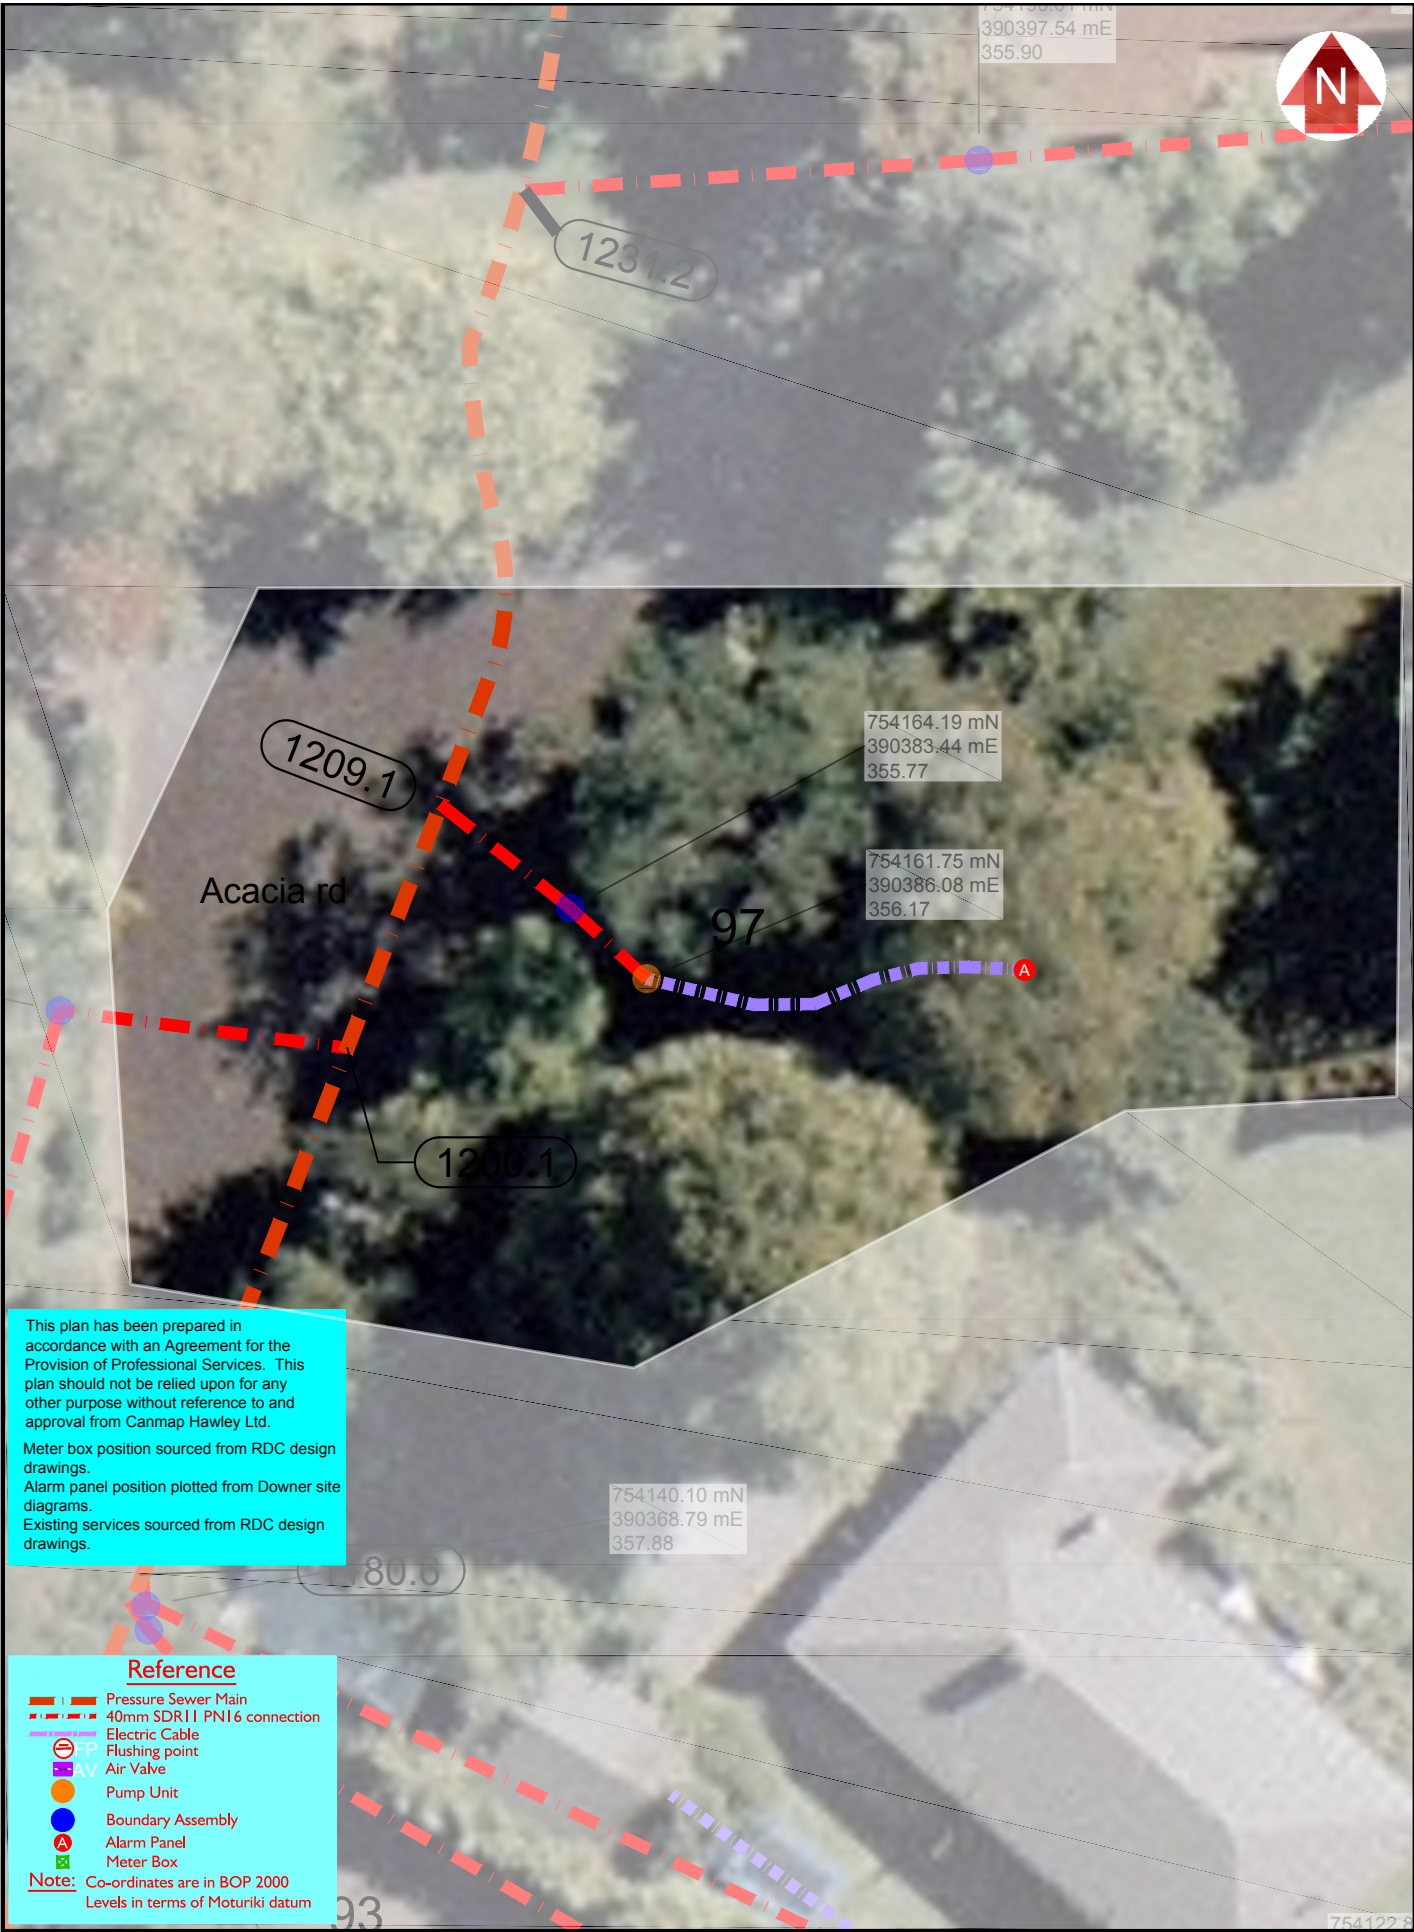

This plan has been prepared in accordance with an Agreement for the Provision of Professional Services. This plan should not be relied upon for any other purpose without reference to and approval from Canmap Hawley Ltd.
 Meter box position sourced from RDC design drawings.
 Alarm panel position plotted from Downer site diagrams.
 Existing services sourced from RDC design drawings.

Reference

- Pressure Sewer Main
- 40mm SDR11 PN16 connection
- Electric Cable
- Flushing point
- Air Valve
- Pump Unit
- Boundary Assembly
- Alarm Panel
- Meter Box

Note: Co-ordinates are in BOP 2000
 Levels in terms of Moturiki datum

ROTORUA
 PO Box 396
 PH. 07 **349 8470**
 FAX. 07 **347 6652**
www.canmaphawley.co.nz

Site No: 03 050

OKAREKA SEWER SCHEME
 SITE INSTALLATION
97 Acacia Rd

DRAWING Name:
 9276-106-A SHEETS 251-257
 Scale @ A4 1:250
CHECK BEFORE YOU DIG