


Printed: 19/04/2019 10:00:00 AM
 Project: 03271 - 51 Summit Rd
 Drawing: 9276-106-A SHEETS 71-80

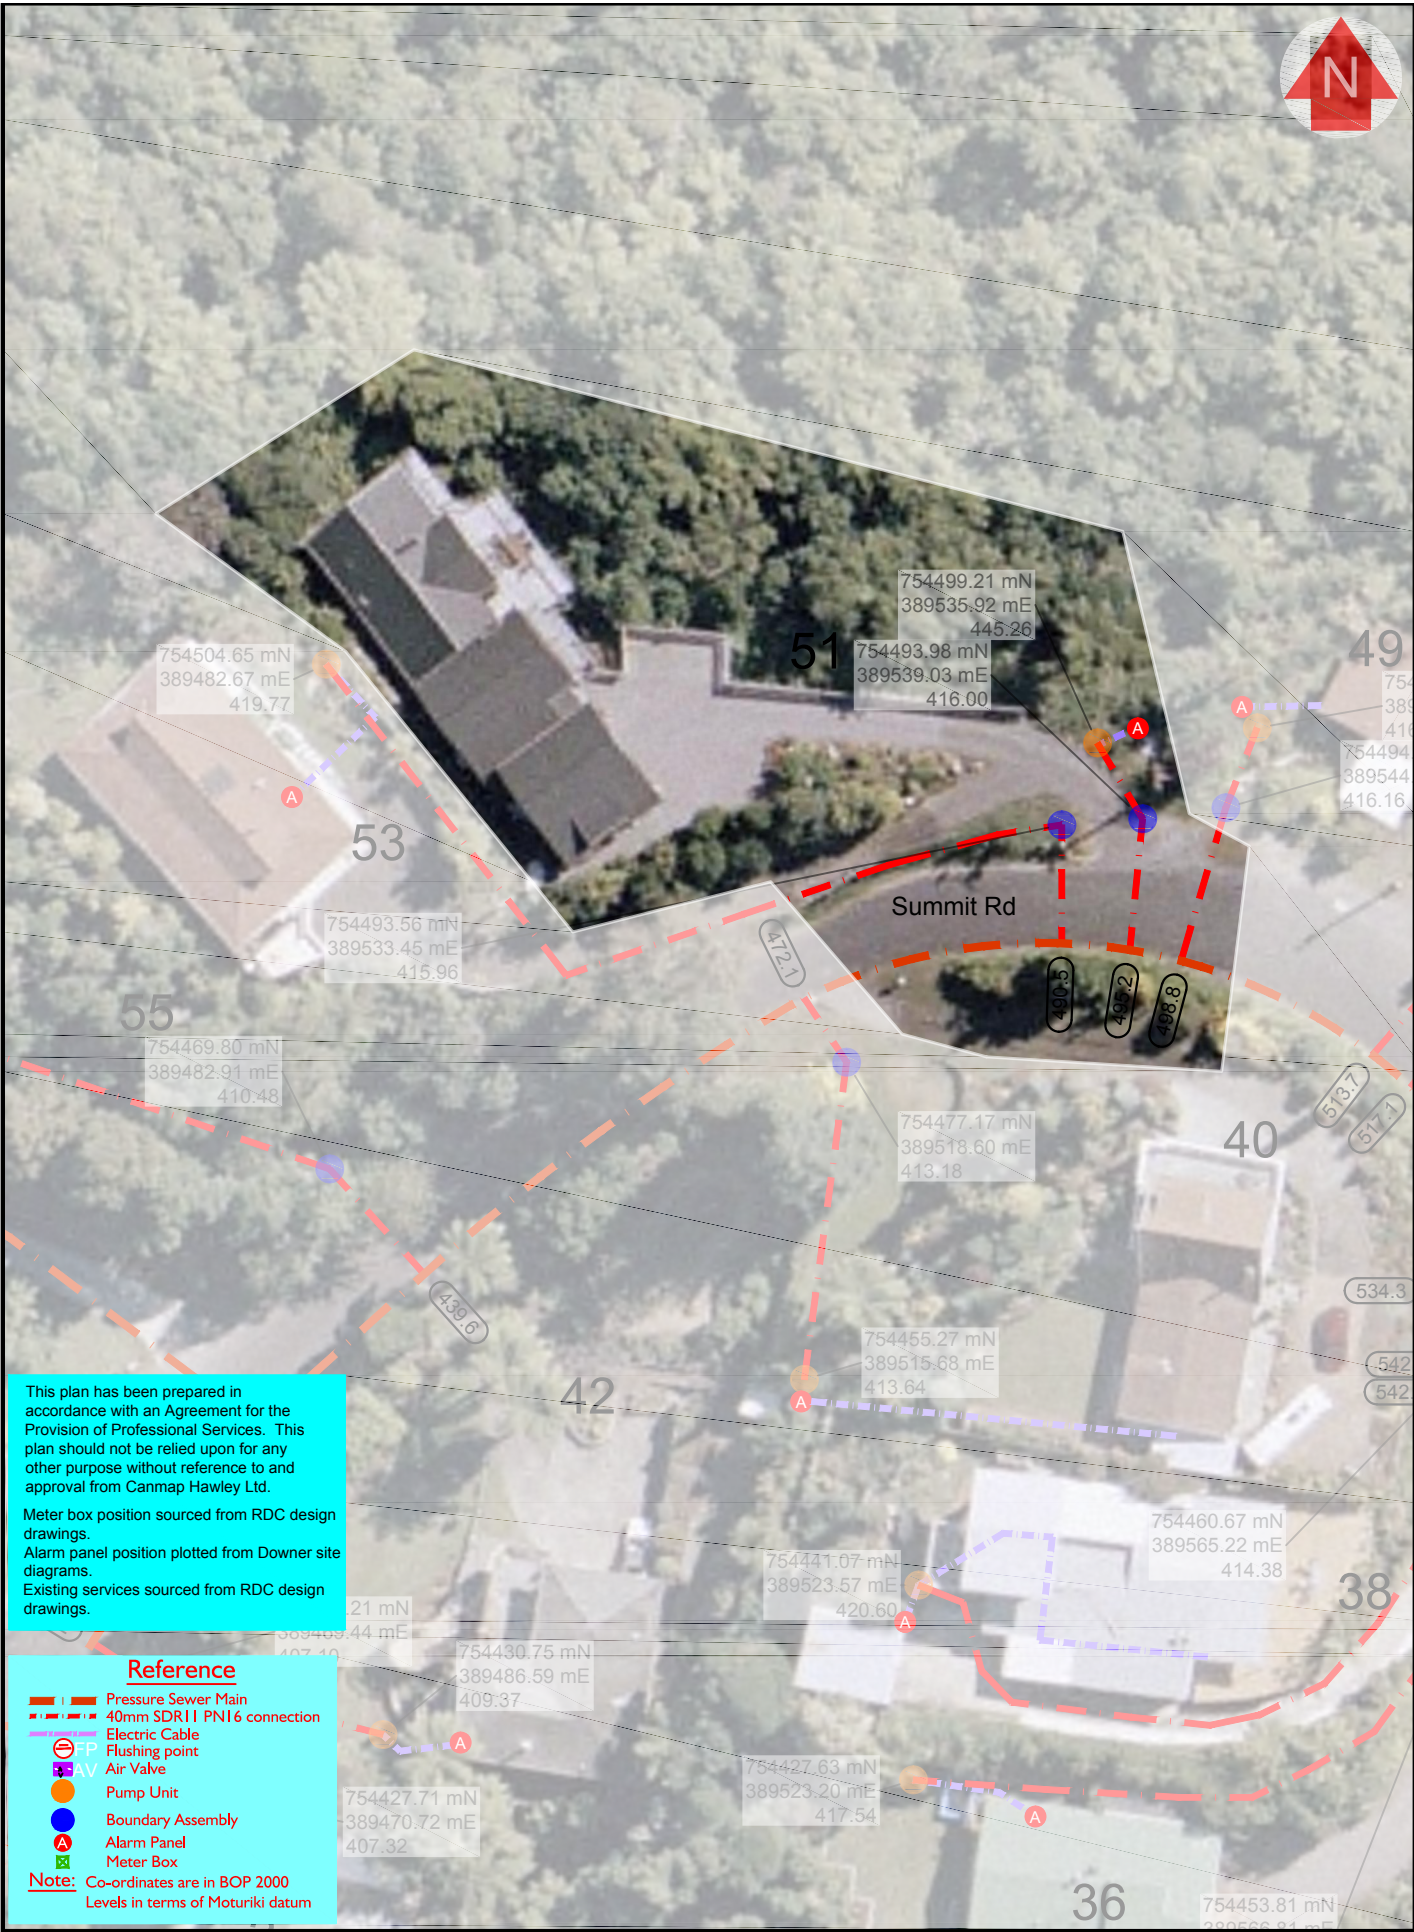

This plan has been prepared in accordance with an Agreement for the Provision of Professional Services. This plan should not be relied upon for any other purpose without reference to and approval from Canmap Hawley Ltd.
 Meter box position sourced from RDC design drawings.
 Alarm panel position plotted from Downer site diagrams.
 Existing services sourced from RDC design drawings.

Reference

- Pressure Sewer Main
- 40mm SDR11 PN16 connection
- Electric Cable
- Flushing point
- ⊖ Air Valve
- Pump Unit
- Boundary Assembly
- A Alarm Panel
- Meter Box

Note: Co-ordinates are in BOP 2000
Levels in terms of Moturiki datum

ROTORUA
 PO Box 396
 PH. 07 **349 8470**
 FAX. 07 **347 6652**
www.canmaphawley.co.nz

Site No: 03 271

OKAREKA SEWER SCHEME
 SITE INSTALLATION
51 Summit Rd

DRAWING Name:
 9276-106-A SHEETS 71-80
 Scale @ A4 1:500
CHECK BEFORE YOU DIG