


Printed: 19 Jul 2017 11:52:17 AM  
 Project: 9276-106-A SHEETS 191-200  
 Drawing: 9276-106-A SHEETS 191-200  
 Client: Downer  
 Date: 19 Jul 2017 11:52:17 AM  
 File: 9276-106-A SHEETS 191-200.dwg

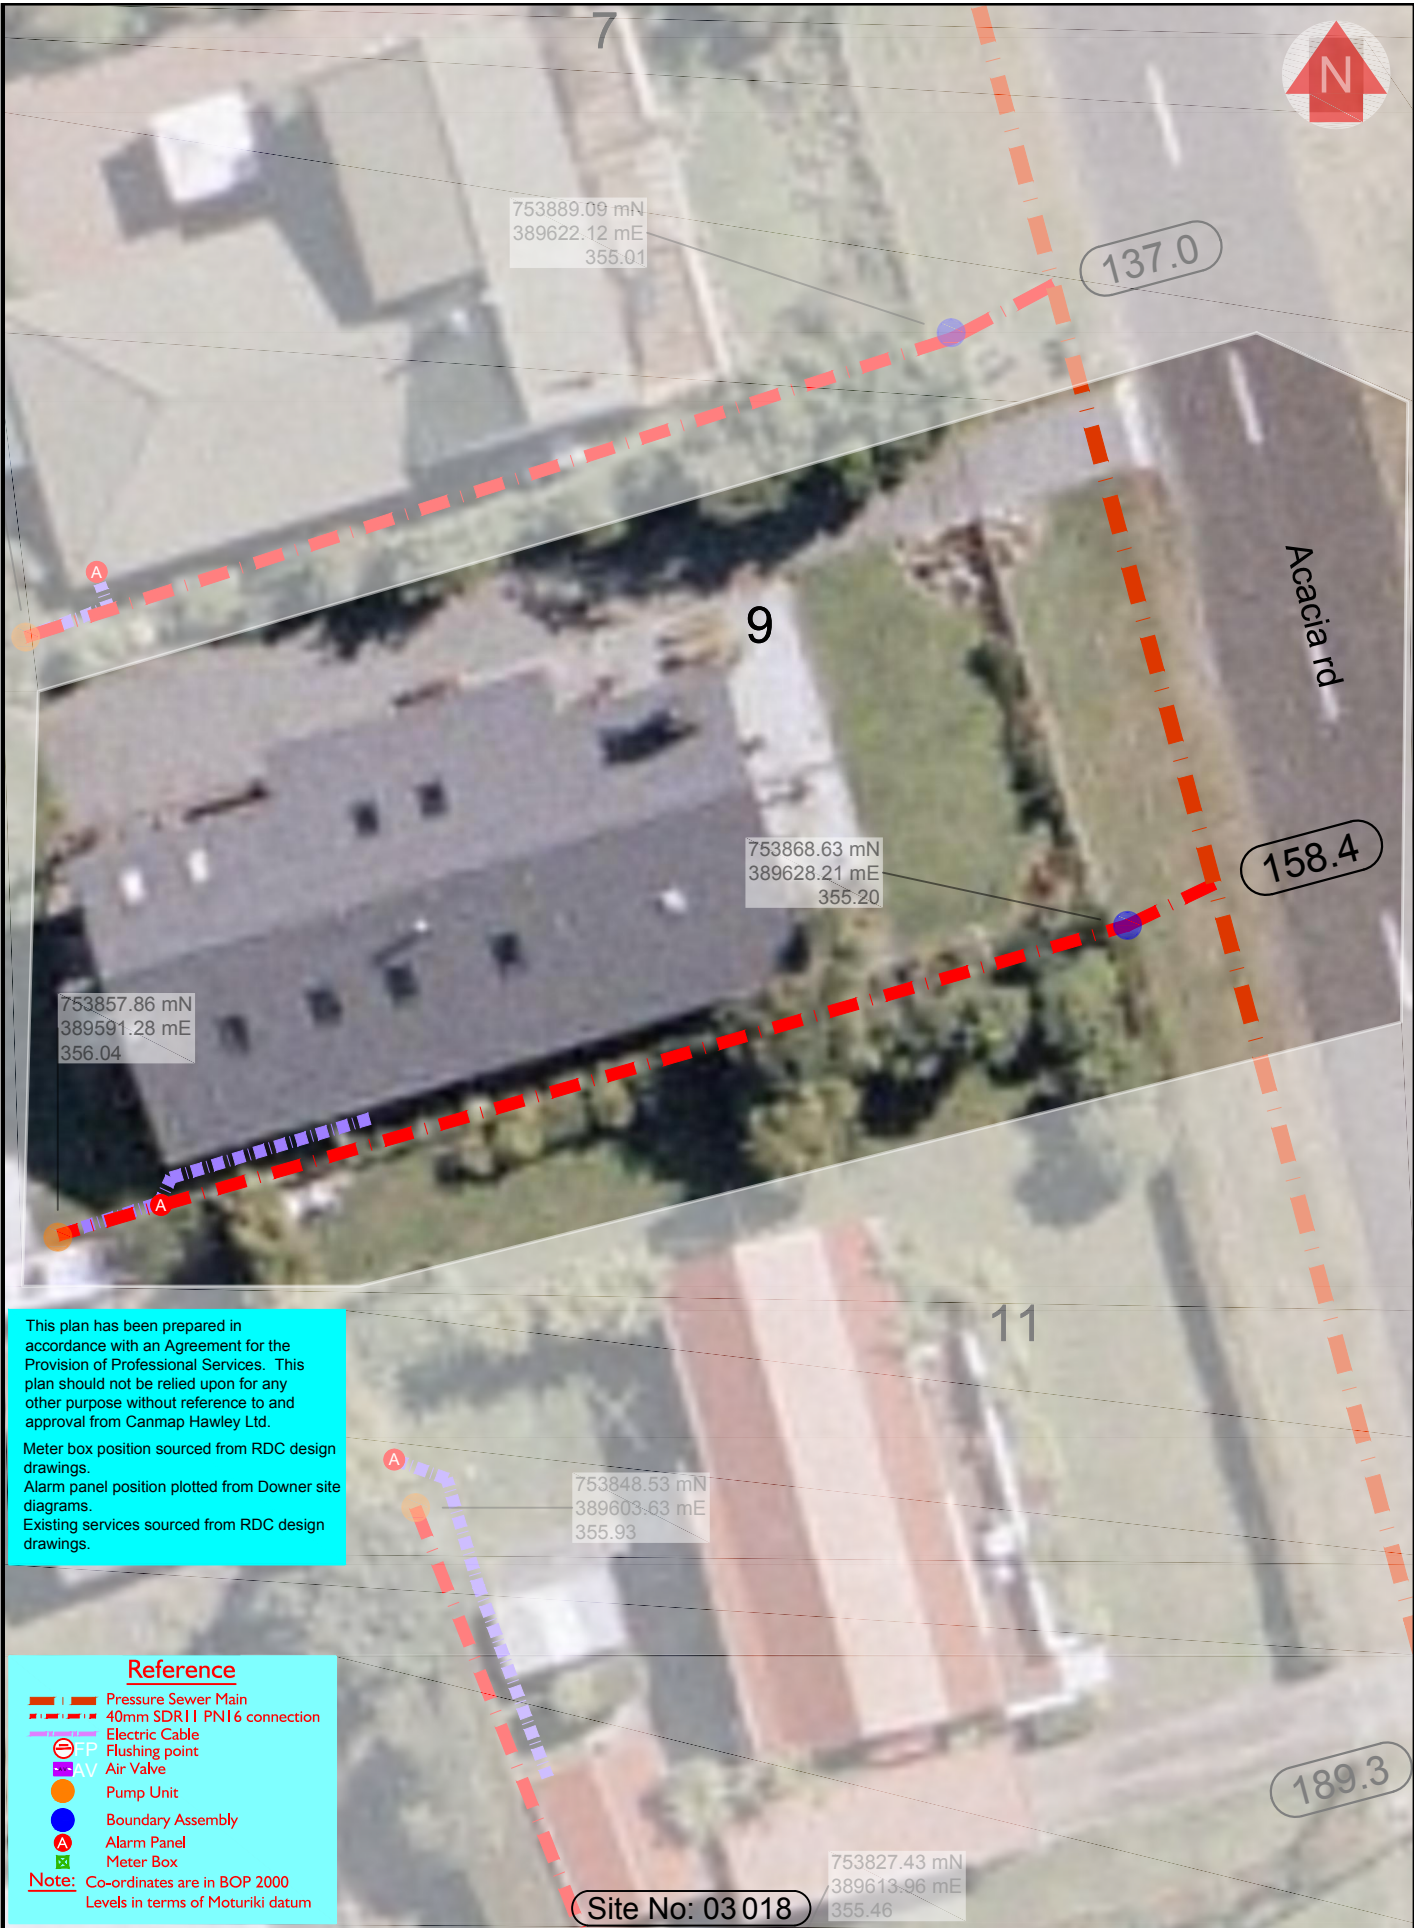

This plan has been prepared in accordance with an Agreement for the Provision of Professional Services. This plan should not be relied upon for any other purpose without reference to and approval from Canmap Hawley Ltd.

Meter box position sourced from RDC design drawings.  
 Alarm panel position plotted from Downer site diagrams.  
 Existing services sourced from RDC design drawings.

**Reference**

- Pressure Sewer Main
- 40mm SDR11 PN16 connection
- Electric Cable
- ⊖ Flushing point
- ⊖ Air Valve
- Pump Unit
- Boundary Assembly
- A Alarm Panel
- M Meter Box

**Note:** Co-ordinates are in BOP 2000  
 Levels in terms of Moturiki datum

**CANMAP HAWLEY**  
 MAKING SENSE OUT OF SPACE

ROTORUA  
 PO Box 396  
 PH. 07 **349 8470**  
 FAX. 07 **347 6652**  
[www.canmaphawley.co.nz](http://www.canmaphawley.co.nz)

**Downer**

OKAREKA SEWER SCHEME  
 SITE INSTALLATION  
**9 Acacia Rd**

DRAWING Name: 9276-106-A SHEETS 191-200  
 Scale @ A4 1:250  
**CHECK BEFORE YOU DIG**